

**Industrial/Warehouse for
Lease: 15,155 SF**

**Riverworks at 133 Elm Street,
Winooski, Vermont**
Flexible Layouts


Open space featuring outside parking, 1 loading docks, 2 at grade doors, with 27'-35' high bay clearance. The building is surrounded by woods, just 5 minutes from interstate 89.


Offered


For Lease \$8.00/SF
NNN.....\$2.44/SF

Property Metrics

Property Type Office/Industrial
Square Footage 15,155±

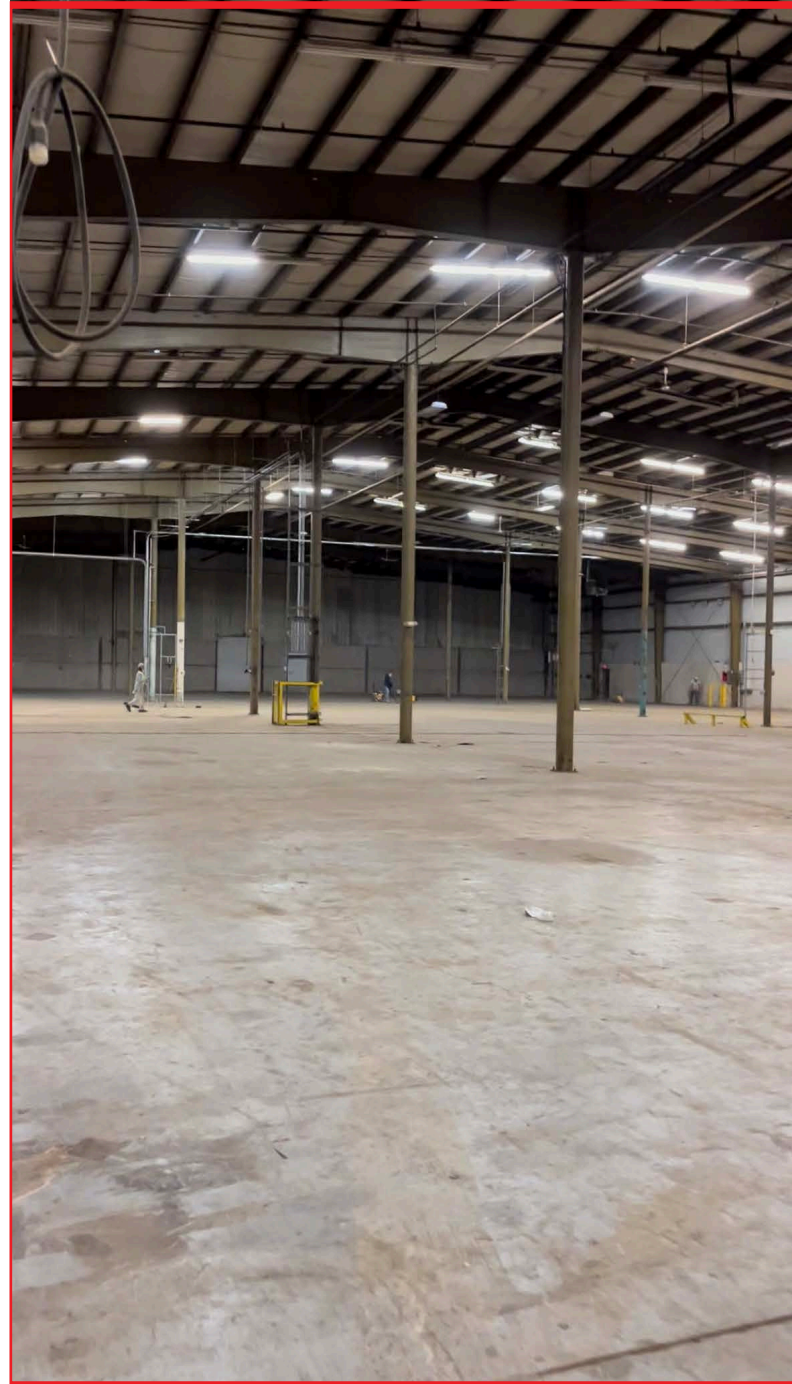

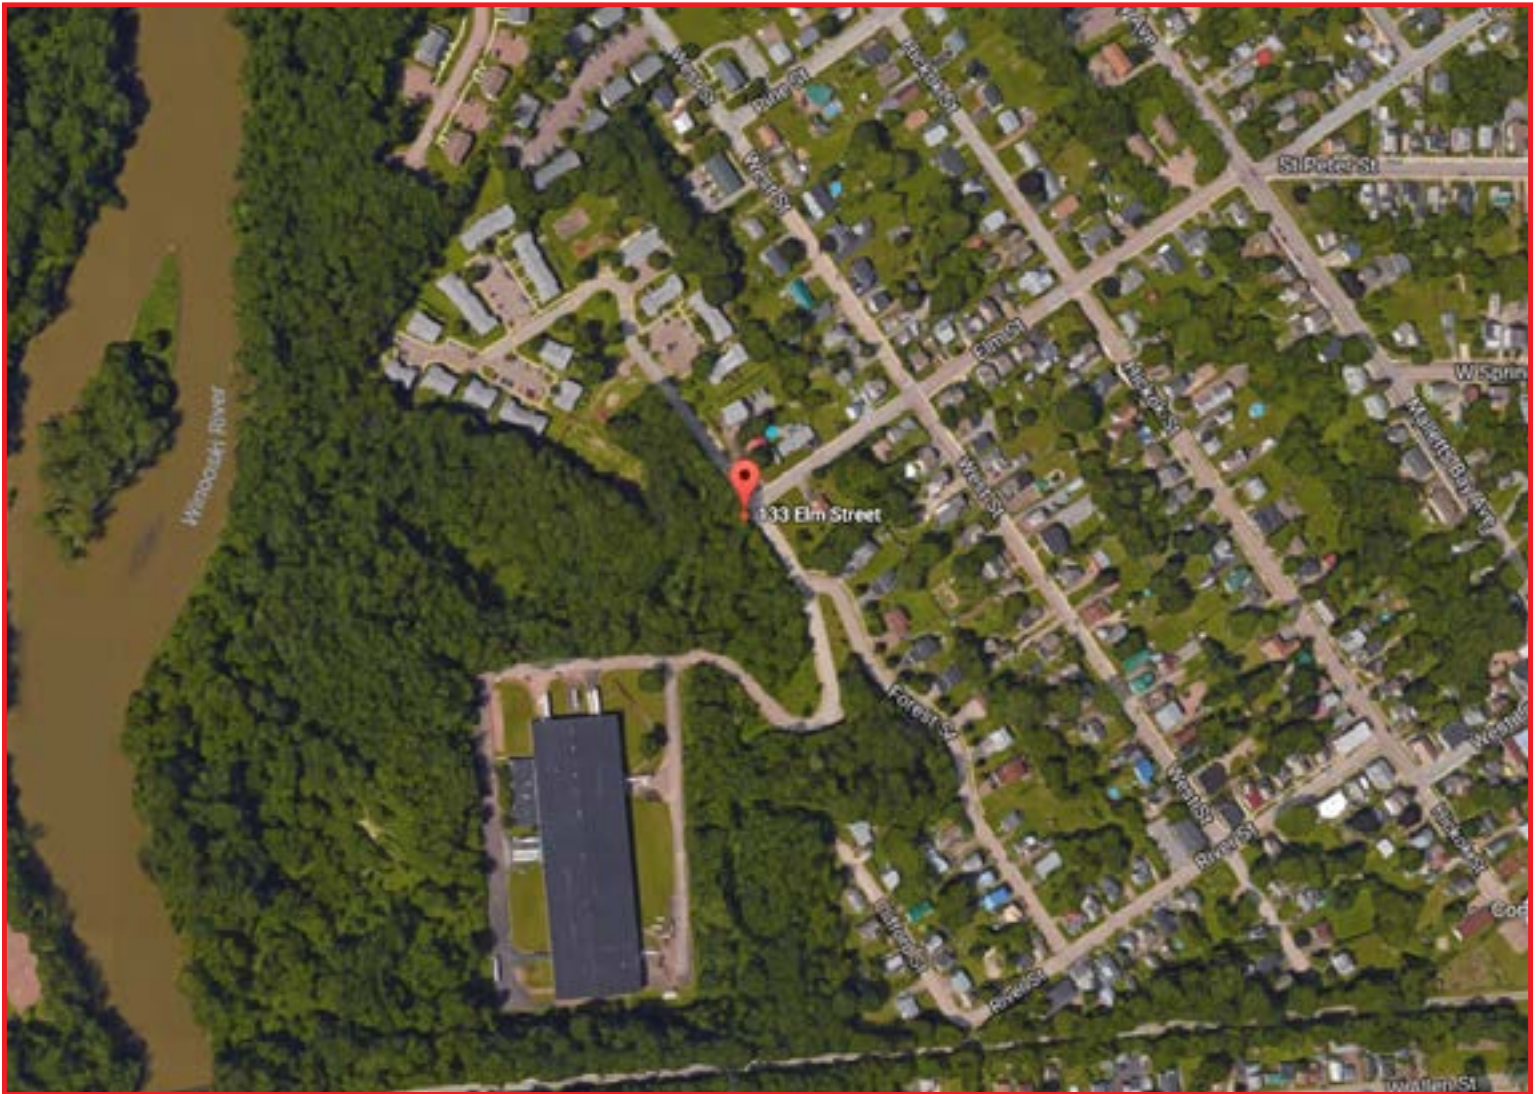

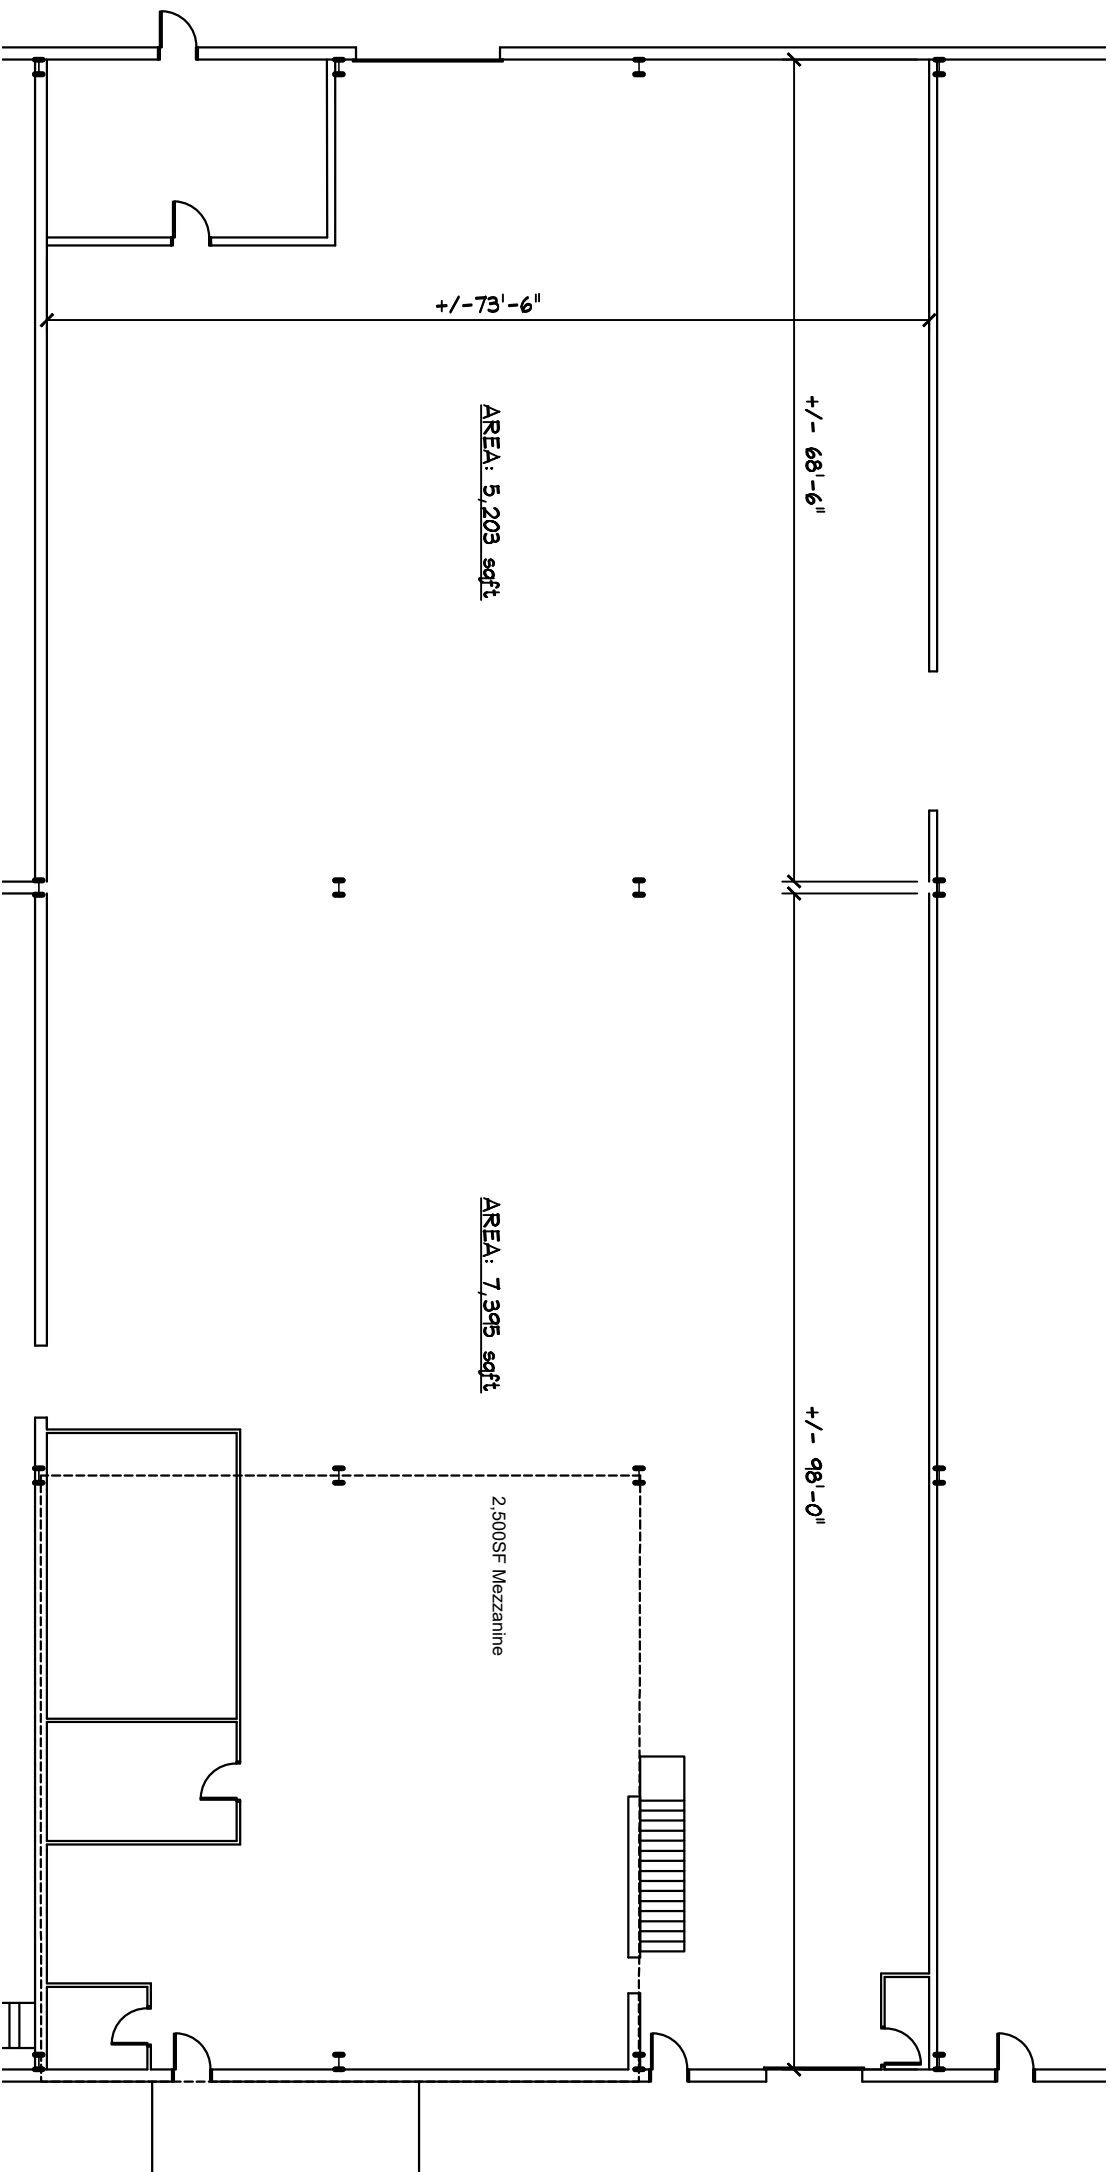

FLOOR PLAN SCALE: 1/16" = 1'-0"

FOR REVIEW ONLY,
NOT FOR CONSTRUCTION

THIS DRAWING IS THE PROPERTY OF G4 DESIGN STUDIOS, LLC AND IS NOT TO BE COPIED, REPRODUCED, OR THE CONTENT THEREOF USED, IN WHOLE OR IN PART, WITHOUT THE PRIOR WRITTEN CONSENT OF STEVE GUILD



RIVERWORKS
AS-BUILT CONDITIONS

1/14/2023

SHEET TITLE:
EXISTING
CONDITIONS

DRAWING NO:
A-2